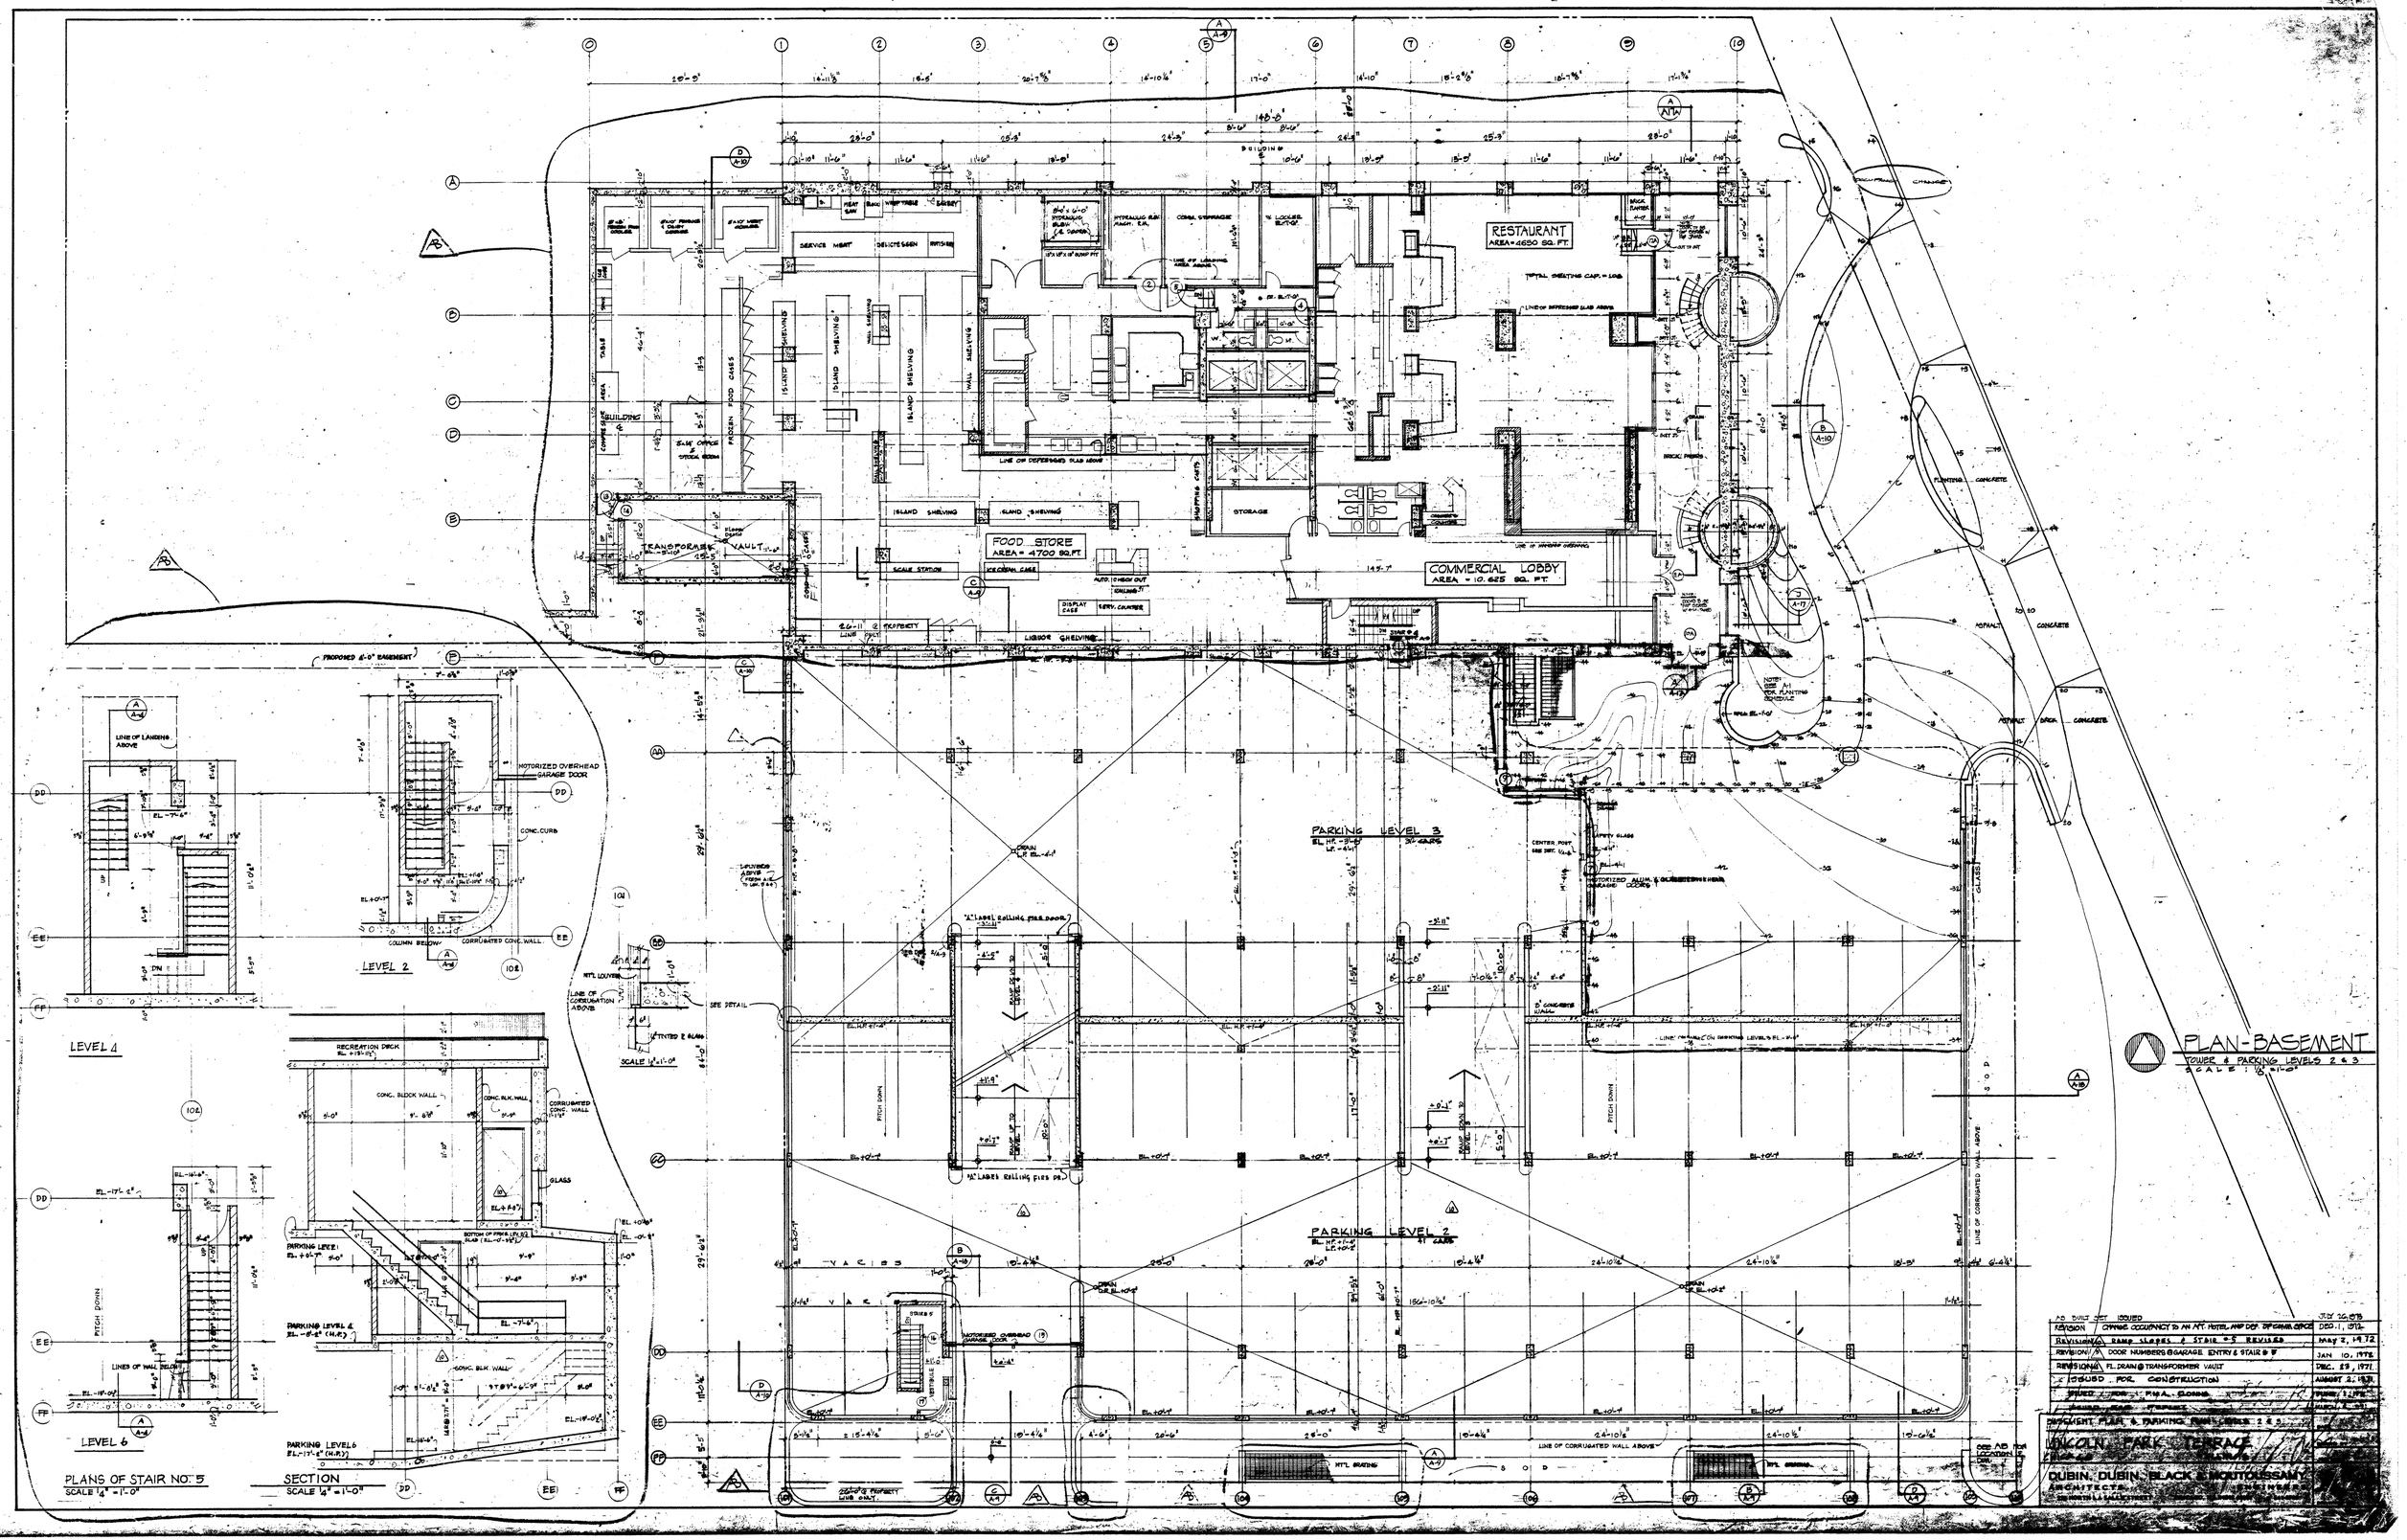

RESTAURANT
AREA = 4650 SQ. FT.
FOOD STORE
AREA = 4700 SQ. FT.
COMMERCIAL LOBBY
AREA = 10,625 SQ. FT.
PARKING LEVEL 3
PARKING LEVEL 2
LEVEL 4
LEVEL 2
LEVEL 6
PLANS OF STAIR NO. 5
SCALE 1/4" = 1'-0"
SECTION
SCALE 1/4" = 1'-0"
PLAN-BASEMENT
TOWER & PARKING LEVELS 2 & 3
SCALE 1/8" = 1'-0"
AS BUILT SET ISSUED
JULY 26, 1973
REVISION 1 CHANGE OCCUPANCY TO AN ART HOTEL AND DEP. OF COMM. SPACE
DEC. 1, 1972
REVISION 2 RAMP SLOPES & STAIR #5 REVISED
MAY 2, 1972
REVISION 3 DOOR NUMBERS @ GARAGE ENTRY & STAIR # 5
JAN 10, 1972
REVISION 4 FL. DRAIN @ TRANSFORMER VAULT
DEC. 23, 1971
ISSUED FOR CONSTRUCTION
AUGUST 2, 1971
ISSUED FOR FINAL CLOSING
ISSUED FOR PERMIT
BASEMENT PLAN & PARKING PLAN LEVELS 2 & 3
LINCOLN PARK TERRACE
DUBIN, DUBIN, BLACK & MOUTOUSSAMY
ARCHITECTS
ENGINEERS